

Sweet Home Mahler WRF Improvements Project

ADDENDUM NO. 3

FOR

MAHLER WRF PHASE 1 BID DOCUMENTS

To: All Prospective Bidders and Plan Holders of Record

The following clarifications, changes, additions and/or deletions are hereby made a part of the bid documents for the construction of the above referenced project as fully and completely as if the same were fully set forth therein.

This Addendum consists of 14 pages of changes, additions and/or deletions, including Attachments. Contractor shall contact City immediately if not all sheets are received.

RESPONSES TO BIDDER QUESTIONS

The following questions have been submitted by Pre-Qualified Bidders. Owner responses are denoted with an "R:".


Q1: Drawing C-061: Note 6 on plan sheet C-061 calls for furnish and installation of an 18" DI 45 DEG HORIZ BEND MJ fitting. Please confirm the intent is to furnish and install a 10" DI 45 DEG HORIZ BEND MJ fitting in this location.

R: The correct size fitting is 10-inch.

Q2: Drawing C-060/C-061: Note 10 on plan sheet C-060 and C-061 calls for furnish and installation of a 10" blind flange. A blind flange will not bolt up to the 10" MJ TEE. Is the intent for this to be a 10" MJ plug in one side of the 10" MJ TEE in this location? Please confirm.

R: Yes. Install a MJ Plug instead of a blind flange at this location.

Q3: Drawing M-111/M-114/C-061: I'm trying to determine the design intent for the 12" and 24" dia. IPS FM piping and valve highlighted below. This connects the interior flanged piping to buried DI to HDPE transitions. These are from plan sheets C-061, M-111, and M-114. The pipe profiles are shown on plan sheet C-072. Is the intent for this piping also to be flanged ductile iron? Please advise.

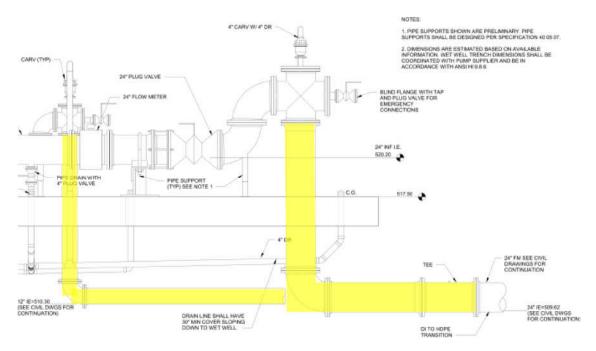

R: Yes. The intent is to have ductile iron flanged pipe through the tee that connects the two force mains with valve.

Q4: Drawing C-003/ Detail 4: The EBAA 2100 Series and EBAA 2000PV Series called out in 4/C-003 are both only available up to size 12". What should be used for 24" diameter HDPE connections to flanges and/or M.J. fittings

R: The EBAA Products called out are available in 24-inch. This has been confirmed with the manufacturer.

Q5: Specification 08 80 00 - Glazing: Please provide a specification for glazing type GLZ-1 on the plans. This glass type isn't listed in the Glazing specification (Section 088000).

R: See changes to Specification 08 80 00 in the section below.

Q6: Drawing A-100: We are installing these new doors into this existing building. Have the existing doors been removed by someone else or does the contractor need to plan on removing and replacing existing doors?

R: Contractor to remove and replace existing doors.

Q7: C-060, C-062 & M-111: On page M-111 the hose bibs are fed off of utility water, but utility water is not in the pipe schedule, and the utility water line does not appear to tie into anything. C-062 does not show a connection point for this utility water line. Please confirm what material type this pipe system is to be and where it is routed from.

R: The IPS hose bibs will feed off the potable water system during Phase 1 until Phase 2 utility water system is constructed. Connect the utility water to the new potable water service installed near the IPS. Pipe material shall be PEX per Addendum #2.

Q8: C-060: the Gas line is not listed in the pipe schedule, what material does the 1" Gas line need to be?

R: Coordinate with gas utility.

Q9: Section 09 91 13: Are the interior CMU walls of the existing electrical building supposed to be painted?

R: Yes.

Q10: Section 09 96 00: In the high-performance coating spec there is a coating system for submerged concrete, system 5. In the finish schedule shown in the high-performance coating spec this system is not called out to be applied on the project. Will coating system 5 be used on the project?

R: System 5 will not be used on this project.

Q11: Sheet E-101: Please confirm that the hatched lines are duct bank that are to be demolished completely, and not just pulling wire out of existing ductbank. If the existing ductbank needs to be completely demolished then trenches will need to be dug through the existing plant. will sidewalk and asphalt replacement over demolished ductbank be necessary?

R: Yes, demolish the ductbanks, completely.

Q12: Sheet A-005: Where does the foundation drain along the new electrical/blower building drain to? This drain is not show in the civil drawings. Can a detail be provided for the routing of this drain?

R: Daylight the foundation drain out of the slope east of the new MEB building.

Q13: Sheet E-106: Does the existing pad and slab under the old generator in the existing electrical building need to be demolished?

R: Yes, demo existing genset slab. Reference structural drawings for new concrete slab under MCC-300.

Q14: Sheet S-100: Where does the perforated drain along the retaining wall drain to? This drain is not shown in the civil drawings.

R: Daylight the perorated drain pipe on Wall 1/6 out of the slope east of the new MEB building. Daylight the drain pipe from the south wall onto the gravel roadway.

Q15: Section 26 32 00: What is the weight of the owner provided generator? Contractor will need to know the weight to properly coordinate setting the generator.

R: 7,670 lbs wet

Q16: Section 26 32 00: What is the fuel tank capacity of the owner provided generator?

R: 2,000 gal

Q17: Sheet S-003: Is the 4,000 psi mix only used in the IPS structure?

R: Use 4,000 psi strength mix for the IPS structure and the slab over the IPS Structure.

Q18: Sheet S-003: Does the Slab over the top of the IPS structure need to be the 4,000 psi mix as well?

R: Yes.

Q19: Sheet S-003: All other concrete on the job, including the building and generator slabs is to be the 3,000 psi mix?

R: Yes, unless noted otherwise. The slab on grade next to (not over) the IPS shall be 3,000 psi.

Q20: Sheet C-007: Please provide as-builts and weight or manufacturer and model number of the existing bathroom facility to be relocated so we can properly coordinate a safe pick plan.

R: Contractor may make a request to the City for As-builts per Section 00 20 00 Article 5 Item 5.02 Existing Site Conditions.

Q21: Sheet I-112: We cannot find details or information on this stilling well. Is there a detail for it and where is it located in the pump station?

R: The stilling well shown on I-112 shall be as follows:

- Still well shall be constructed of Schedule 80 PVC pipe
- Inside diameter of pipe shall be at least 1/2-inch larger than outside diameter of level instrument
- Pipe shall extend from 6-inches above bottom of wet well to 6-inches below mounting hardware at top of wet well
- 1/4-inch holes shall be drilled on both sides of pipes
- Pipe shall be supported from side of wet well with SS pipe clamps on SS unistrut, anchored into structure with two 3/8-inch SS epoxy anchors
- Any required bends in the pipe shall be of a long enough radius to pass the transducer
- Top of transducer cable shall be supported at top of wet well with a manufacturer provided mounting clamp, supported by a SS J-hook bracket anchored to wall with SS anchors.

Q22: Section 26 32 00: Who is responsible to provide the anchorage calculations on the owner provided generator?

R: The Contractor is responsible.

Q23: Sheet E-101: This page shows the OH powerline going over the railroad is to be removed, please confirm that this is correct.

R: Yes, existing OH power lines as shown on the drawings shall be demolished, including across the railway. Contractor to coordinate with power utility company.

Q24: Section 01 12 16: In order to bypass flows in the existing 18", 21" and 24" influent lines, we will need to draw out of upstream manholes. Where are the closest manholes located?

R: There is a manhole on the 21-inch influent sewer to the East as shown on the existing conditions plan. The manholes for the 18-inch and 24-inch are south of the railroad tracks.

Q25: Section 01 12 16: If these manhole are off the WTP property, will we be able to access them for bypassing, such as the two lines heading towards the railroad ROW?

R: See Section 01 12 16-3.03.C for Potential Work Sequence.

Q26: Section 32 31 13 & Sheet C-002: Specification 32 31 13 says knuckle finish top and bottom. Plan page C-002 says twisted and barbed top and bottom. Which is it?

R: Provide twisted and barbed finish at the top and bottom.

Q27: Section 32 31 13 & Sheet C-002: Spec Section 3.04 H. Razor Wire says, "install as indicated and per manufacturer's recommendations". Page C-002 says "sst barbed tape" but doesn't show it on the drawing or provide a specification for it. It is pointing to the barbed wire, but no razor wire is actually shown in detail. Does the fence have razor wire/barbed tape in addition to barbed wire?

R: Razor wire/bared tape is not required.

Q28: Section 00 43 39: Specification 00 43 39 for local business participation is not stated to be due with the bid. Please confirm if the Good Faith efforts documentation must be submitted with bid.

R: See Section 00 43 39 that states "Bidders shall submit forms as part of their proposal. The City reserves the right to take this information into consideration when evaluating bids for responsiveness."

Q29: Instructions to bidders – Article 21: article 21 of the instructions to bidders states that Federal Davis-Bacon wage rates apply in addition to BOLI rates. Which publication (building/heavy/highway) is applicable, for the Davis-Bacon rates.

R: Heavy Construction

Q30: standard general conditions/ 00 73 43: Paragraph 7.11 E 2 of the standard general conditions states the wage rates that apply to this contract are the BOLI wages from the January 1, 2021 publication date. Specification 00 73 43 states the wage rates are to be the BOLI wages published July 1 2022. Please confirm publication is the correct one to use.

R: Use current published Oregon BOLI wage rates for July 1, 2022.

Q31: standard general conditions/ 00 73 43: GC article 6.01 item F.11 requests our builders risk policy cover owner procured electrical gear for an insurance sublimit of \$5,000,000. Builders risk policies are written based on the value of the item being covered. Please provide the value of the owner procured items the GC is required to extend coverage to so we can include in our BRI policy.

R: The expected value of the Owner procured items is in the range of 1.5-2 million.

Q32: Section 03 30 00 - 1.03.D.a.5: would ASTM C1293 be accepted over the use of C 1260? **R:** No.

Q33: Section 03 30 00 - 1.03.E.1: who will be responsible for running the trial batches after design being accepted?

R: The Contractor.

Q34: Section 03 30 00 - 1.03.E.2: will field test data more distant than 45 days be allowed to be used in lieu of trail batches?

R: No.

Q35: Section 03 30 00 - 1.04.C.3.b: are 56-day strengths required for any submittal?

R: No.

Q36: Section 03 30 00 - 1.04.C.3.d: are drying shrinkage test reports required? Or is the use of an SRA sufficient in lieu of the C 157 data?

R: Tests are required.

Q37: Section 03 30 00 - 2.02.B.1.e.2: will Gsb SSD of 2.50 be allowed instead of the 2.60 requirement?

R: 2.5 will be allowed.

Q38: Section 03 30 00 - 2.02.B.1.e.4&5: will ASTM C1293 be accepted of the use of C 289 & 227? **R:** No.

Q39: Section 03 30 00 - 2.02.b.2.c.1&2: will AASHTO T 96 be accepted over ASTM C131 & 535 per ODOT Specifications?

R: No.

Q40: Section 03 30 00 - 2.02.b.2.c.6: will ASTM C1293 be accepted of the use of C 289?

R: No.

Q41: Section 03 30 00 - 2.03: Is Silica Fume required for Type A and C, or is a water proofing additive sufficient to replace the use of Silica Fume?

R: Yes, pending submittal and approval of waterproofing additive.

Q42: Section 03 30 00 - 2.03.D: Is the use of a shrinkage reducing admixture sufficient in lieu of C 157 data?

R: No.

Q43: Section 03 30 00 - 2.03.E: air target is 4% +/- 1.5% - which of the listed designs will need air entrainment?

R: All concrete exposed to weather.

Q44: Section 31 23 23.33 – 1.05.E.1: Will ASTM D 6103 be used for acceptance/rejection of any concrete?

R: ASTM D 6103 applies to CLSM only.

Q45: Section 31 23 23.33 – 2.01.A: the use of Fly ash is unobtainable due to a shortage in the supply – will the use of slag be allowed?

R: Yes.

Q46: Section 31 23 23.33 – 2.03.e.1&2: will the use of air entrainment be allowed to meet the low PSI requirements?

R: Strength is minimum. Air is not desirable.

Q47: Section 31 23 23.33 – 2.04.b: will slump be measured in lieu of ASTM D 6103? Which will govern should one pass and one fail, but the adjustment of one affects the other?

R: ASTM D6103 governs for CLSM.

Q48: Sheet S-003: PSI and water/cement ratio requirements differ from the table in "Vol 2 – specs – 2.03 Concrete Mixes – Table" Which governs?

R: Sheet S-003 governs.

Q49: Sheet S-003: PSI and water/cement ratio requirements differ from the table in "Vol 2 – specs – 2.03 Concrete Mixes – Table" Which governs?

R: Sheet S-003.

Q50: Sheet S-003: Crystalline waterproofing admix is required – is this allowed to be used as an additive to an existing design for use of field data?

R: Yes.

Q51: Sheet S-003: Weather resistance: will the calcium nitrate corrosion inhibiter need to be placed during the batching process, or is this provided by the contractor after placement?

R: Place during batching process.

Q52: Sheet E-051: The Drawing shows a 12" and 24" flow meter, but the specs list a 8" and 24" meter.

R: 8-inch and 24-inch flow meters are the correct size meters. Refer to Sheet M-111.

Q53: Section 31 00 00 3.07 A. The specification states "The owner has identified a site for disposal of clean excess excavated earth materials...". Is this a City owned site? If not a City owned site, please provide contact for additional information. Is there a cost for disposal at this site? Is the contractor responsible for grading of pile at disposal site?

R: This is a City-Owned Site. There is no cost for disposal. Grading of the disposal pile is not required.

CHANGES AND ADDITIONS AND/OR DELETIONS

Additions are shown in underline. Deletions are shown in strikeout.

Changes to the Specifications:

Section 01 10 00 - SUMMARY OF WORK

PART 1 - GENERAL

Item 1.03 OTHER CONTRACTS, Number B.


Replace the existing paragraph with this one.


Electrical and Control System Integration: The Automation Group (TAG) is the Owner's Integrator-of-Record. TAG shall furnish and install the following: MCC-200, MCC-300, Network Interface Panel (NIP)-200, NIP-300, Main Network Panel (MNP)-100, Control Panel (CP)-300, (5) Influent Pump VFDs, (2) Harmonic filter feeder buckets, and Pump Disconnect Panels, PDP-110-1, PDP-110-2 and PDP-110-03. The Electrical contractor shall install the Owner-provided electrical and controls equipment listed and all wiring including Ethernet Cabling to the New PLC. The electrical contractor shall be present for and assist with the Process Control Equipment Startup and Commissioning. See Section 01 12 16 and the Drawings for detailed Contractor installation requirements related to Owner-supplied equipment.

Section 08 80 00 - GLAZING

- 1) Add to Section 88 00 00 Glazing, Part 2 Products, 2.4 Insulating Glass Units:
- C. Type GLZ-1 Insulating Glass Units: Vision glass, double glazed.
 - 1. Applications: Exterior glazing unless otherwise indicated.
 - 2. Space between lites filled with air.
 - 3. Outboard Lite: Annealed float glass, 1/4 inch (6.4 mm) thick, minimum.
 - a. <u>Tint: Clear.</u>
 - 4. Inboard Lite: Annealed float glass, 1/4 inch (6.4 mm) thick, minimum.
 - a. <u>Tint: Clear.</u>
 - 5. Total Thickness: 1 inch (25.4 mm).
 - 6. Thermal Transmittance (U-Value), See Drawings.
 - 7. Visible Light Transmittance (VLT): See Drawings.
 - 8. Solar Heat Gain Coefficient (SHGC): See Drawings.
- D. <u>Type GLZ-1T Insulating Glass Units: Safety glazing. Same as Type [GLZ-1] except use fully tempered float glass for both outboard and inboard lites.</u>
 - 1. Applications:
 - a. Glazed lites in exterior doors.
 - b. Glazed sidelights and panels next to doors.
 - c. Other locations required by applicable federal, state, and local codes and regulations.
 - 2. Glass Type: Same as Type GLZ-1 except use fully tempered float glass for both outboard and inboard lites.

Changes to the Drawings:	
Replace the following drawings with those attached to this Adder	dum:
E-011	
E-020	
E-104	
E-105	
Add the following drawing attached to this Addendum:	
I-900	
End of Addendum No. 3	
	September 16, 2022
Mr. Greg Springman, Public Works Director	Date

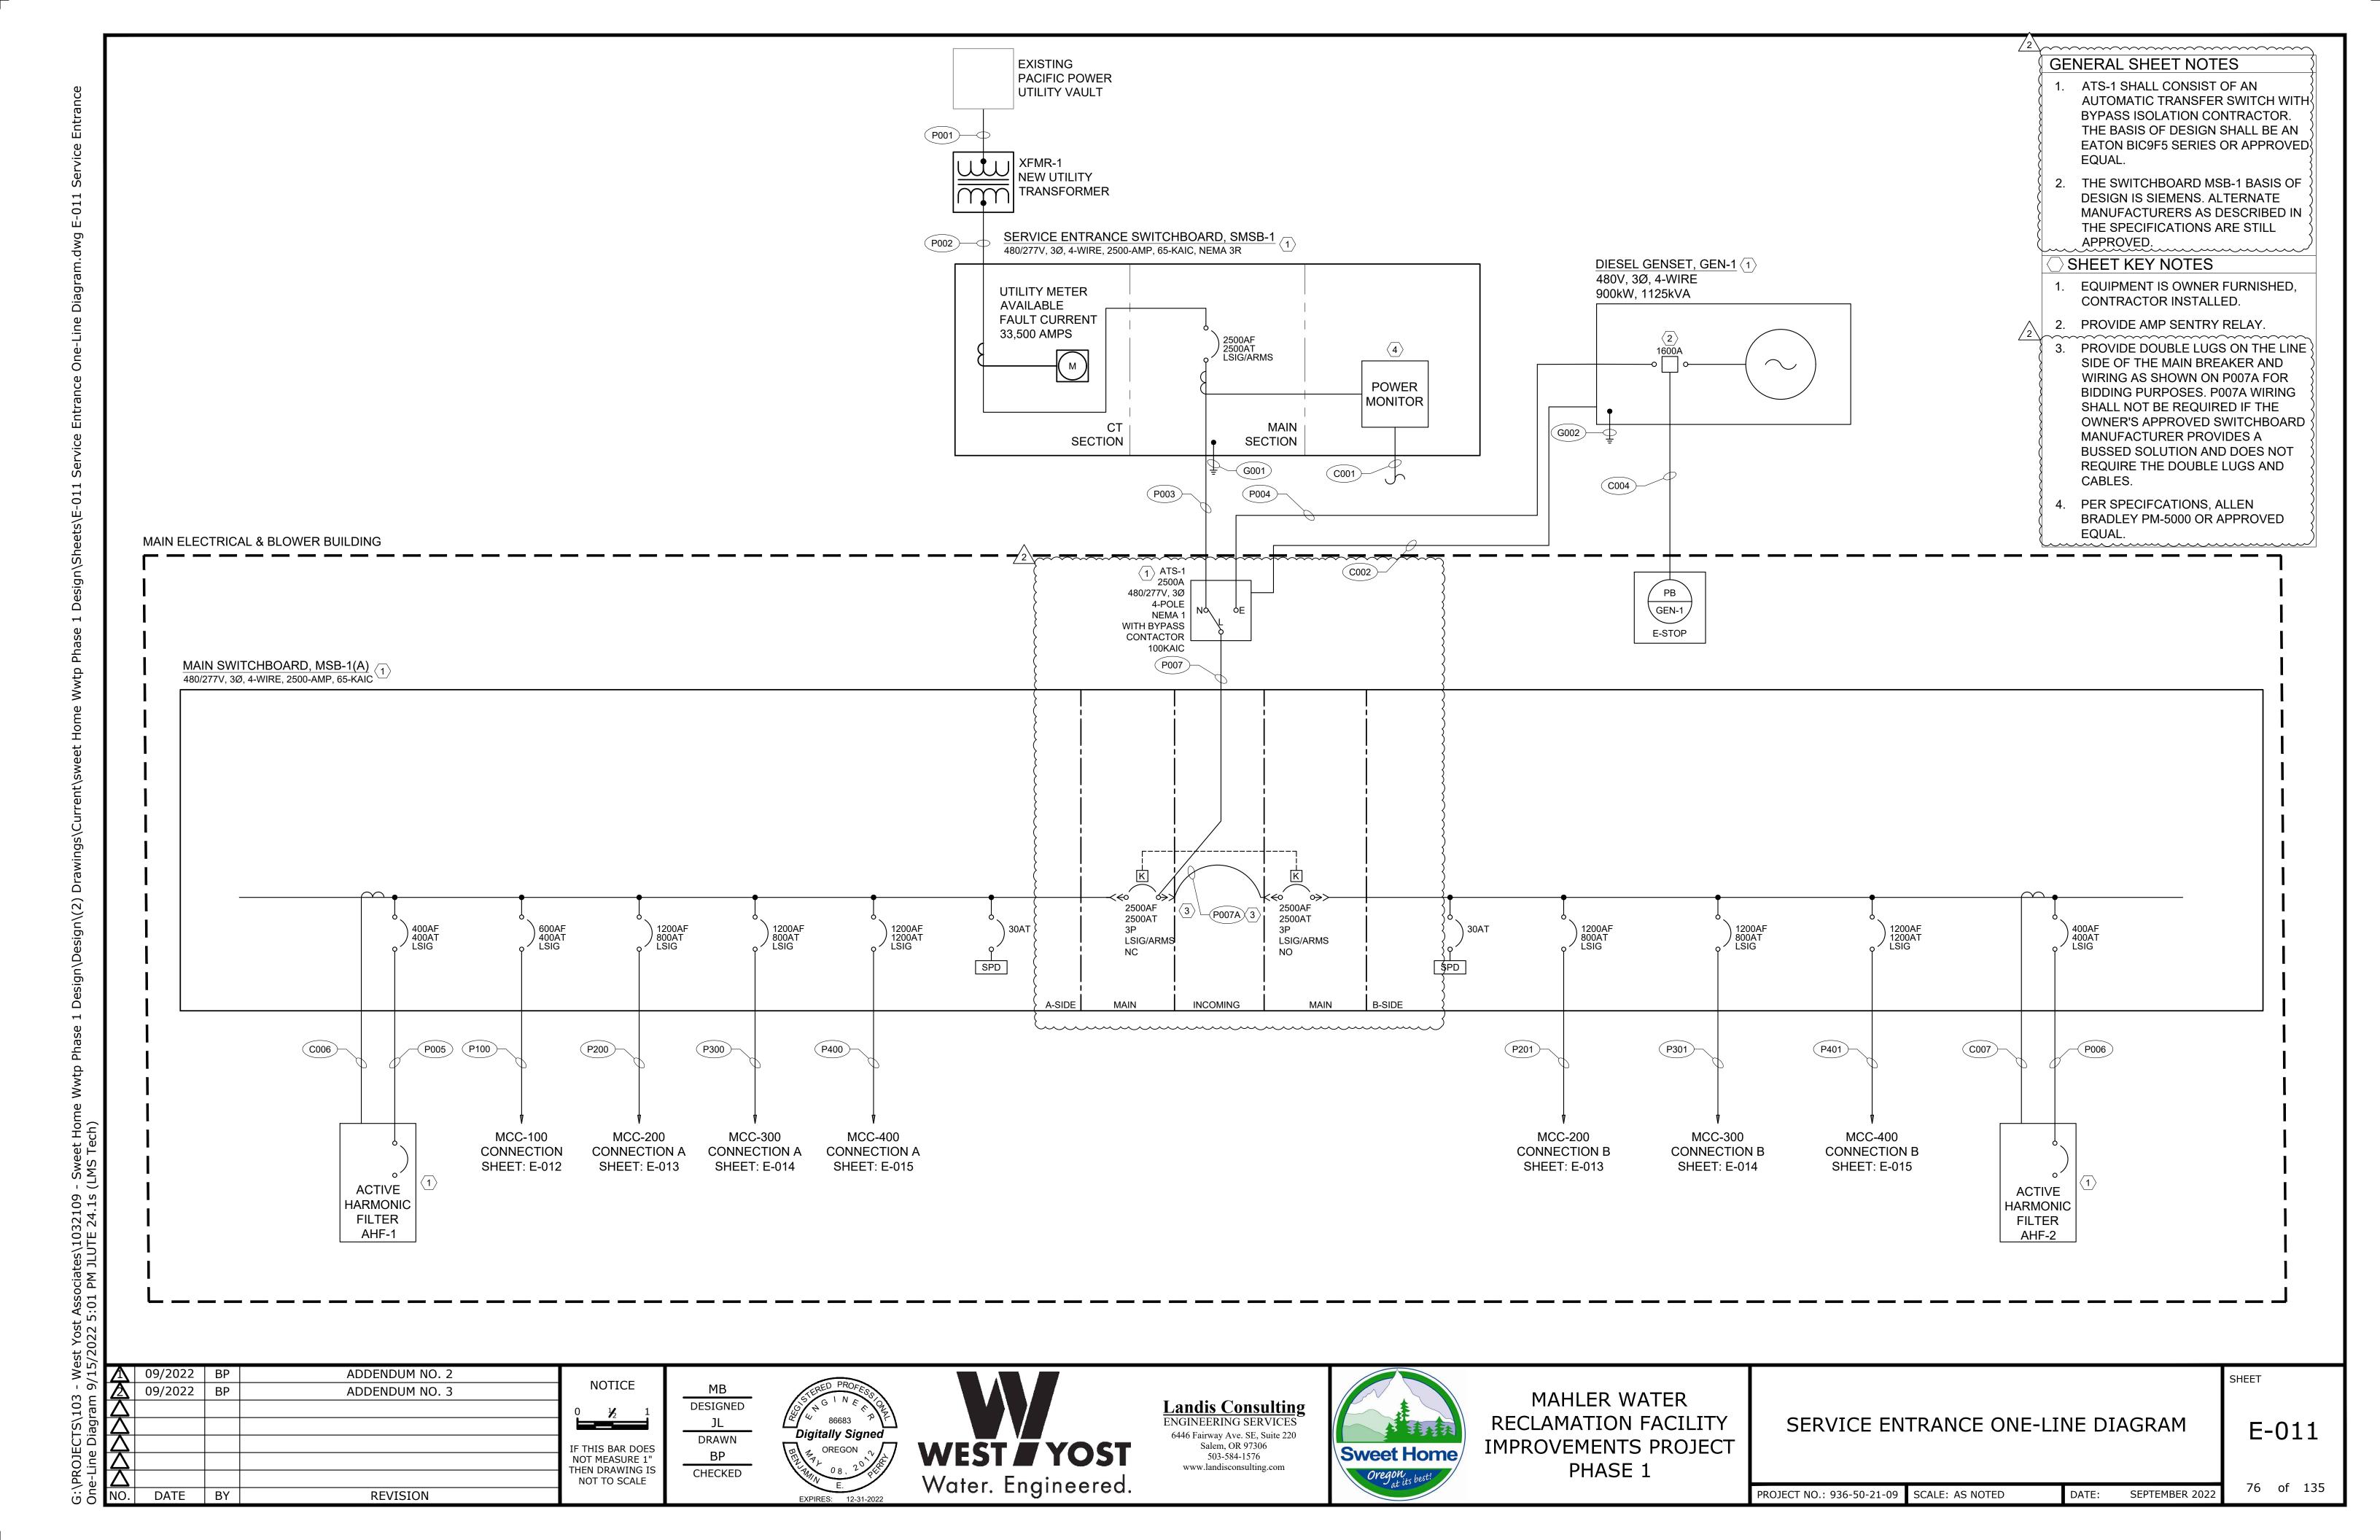

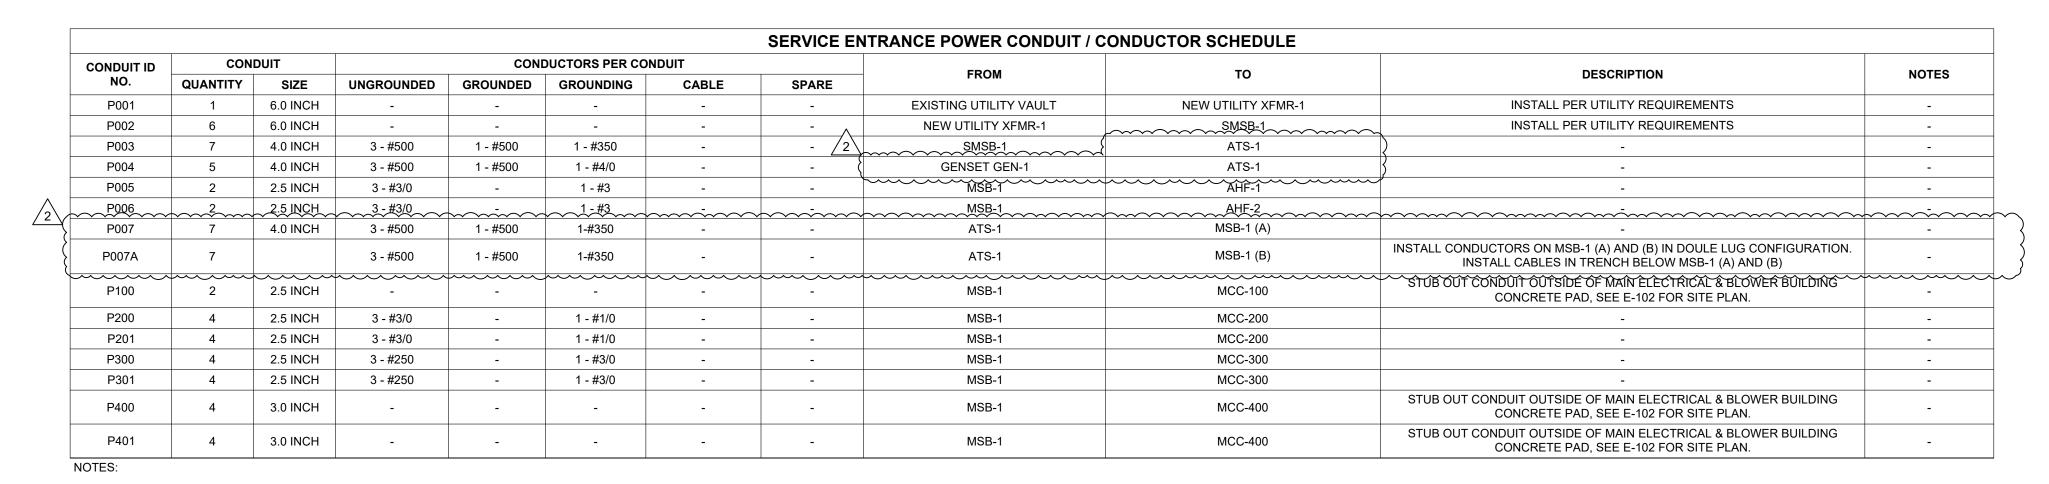

CONDUIT ID	CON	IDUIT		CON	IDUCTORS PER CON	IDUIT					
NO.	QUANTITY	SIZE	UNGROUNDED	GROUNDED	GROUNDING	CABLE	SPARE	FROM	ТО	DESCRIPTION	NOTES
P101	1	0.75 INCH	3 - #12	-	1 - #12	-	-	MCC-100	RAW SEWAGE SCREEN NO.1 SCN-230-10	-	1
P102	1	0.75 INCH	3 - #12	-	1 - #12	-	-	MCC-100	RAW SEWAGE SCREEN NO.2 SCN-230-20	-	1
P103	1	0.75 INCH	3 - #12	-	1 - #12	-	-	MCC-100	SCREENINGS WASH PRESS SWP-230-01	-	1
P104	1	0.75 INCH	3 - #12	-	1 - #10	-	-	MCC-100	GRIT PUMP PMP-240-01	-	1
P105	1	0.75 INCH	3 - #12	-	1 - #12	-	-	MCC-100	GRIT BASIN DRIVE MTR-240-01	-	1
P106	1	0.75 INCH	3 - #12	-	1 - #12	-	-	MCC-100	GRIT CLASSIFIER CLS-240-01	-	1
P107	1	0.75 INCH	3 - #12	-	1 - #12	-	-	MCC-100	DEWATERING CONDITIONING TANK MIXER MIX-250-01	-	1
P108	1	0.75 INCH	3 - #12	-	1 - #12	-	-	MCC-100	DEWATERING SCREW PRESS DEW-250-02	-	1
P109	1	0.75 INCH	3 - #12	-	1 - #12	-	-	MCC-100	DEWATERING CONVEYOR 1 INCLINE CON-250-03	-	1
P110	1	0.75 INCH	3 - #12	-	1 - #12	-	-	MCC-100	DEWATERING CONVEYOR 2 HORIZONTAL CON-250-04 DEWATERING CONVEYOR 3 LEVEL LODER	-	1
P111	1	0.75 INCH	3 - #12	-	1 - #12	-	-	MCC-100	CON-250-05 DEWATERING POLYMER FEED PUMP NO.1	-	1
P112	1	0.75 INCH	3 - #12	-	1 - #12	-	-	MCC-100	DEWATERING POLYMER FEED PUMP NO.1 POL-250-04 DEWATERING POLYMER FEED PUMP NO.2	-	1
P113	1	0.75 INCH	3 - #12	-	1 - #12	-	-	MCC-100	POL-250-05 TRANSFORMER	-	1
P114	1	1.5 INCH	3 - #2	-	1 - #6	-	-	MCC-100	T-ADMIN PANEL	-	1
P115	1	2.5 INCH	3 - #3/0	-	1 - #6	-	-	MCC-100	DP-100	-	1
P116	2	2.0 INCH	3 - #1/0	-	1 - #6	-	-	TRANSFORMER T-ADMIN	T-ADMIN DS	-	1
P117	1	1.25 INCH	3 - #4	-	1 - #8	-	-	PANEL DP-100	TRANSFORMER T-100 HEADWORKS SCREEN NO.1	-	1
P118	1	0.75 INCH	3 - #12	-	1 - #12	-	-	PANEL DP-100	INFLUENT GATE SLG-230-01	WIRE TO PANEL DP-100, CIRCUIT #13,15,17	1
P119	1	0.75 INCH	3 - #12	-	1 - #12	-	-	PANEL DP-100	HEADWORKS SCREEN NO.1 EFFLUENT GATE SLG-230-02	WIRE TO PANEL DP-100, CIRCUIT #19,21,23	1
P120	1	0.75 INCH	3 - #12	-	1 - #12	-	-	PANEL DP-100	HEADWORKS SCREEN NO.2 INFLUENT GATE SLG-230-03	WIRE TO PANEL DP-100, CIRCUIT #25,27,29	1
P121	1	0.75 INCH	3 - #12	-	1 - #12	-	-	PANEL DP-100	HEADWORKS SCREEN NO.2 EFFLUENT GATE SLG-230-04	WIRE TO PANEL DP-100, CIRCUIT #20,22,24	1
P122	1	0.75 INCH	3 - #12	-	1 - #12	-	-	PANEL DP-100	MAIN CHANNEL GATE SLG-230-05	WIRE TO PANEL DP-100, CIRCUIT #26,28,30	1
P123	1	0.75 INCH	3 - #12	-	1 - #12	-	-	PANEL DP-100	BYPASS CHANNEL GATE SLG-230-06	WIRE TO PANEL DP-100, CIRCUIT #32,34,36	1
P124	1	0.75 INCH	3 - #12	-	1 - #12	-	-	PANEL DP-100	MAIN GATE REMOVAL BASIN EFFLUENT CHANNEL GATE SLG-240-04	WIRE TO PANEL DP-100, CIRCUIT #31,33,35	1
P125	1	0.75 INCH	3 - #12	-	1 - #12	-	-	PANEL DP-100	RAW SEWAGE BYPASS CHANNEL GATE SLG-240-05	WIRE TO PANEL DP-100, CIRCUIT #37,39,41	1
P126	2	2.0 INCH	3 - #1/0	-	1 - #4	-	-	T-ADMIN DS	PANEL ADMIN	-	1
P127	1	2.5 INCH	3 - #2/0	-	1 - #4	-	-	TRANSFORMER T-100	PANEL LP-100	-	1
P128	-	-	-	-	-	-	-	-	-	-	-
P129	-	-	-	-	-	-	-	-	-	-	-

[1] EQUIPMENT IS PART OF PHASE 2, NOT PART OF THIS SCOPE.

Λ	09/2022	BP	ADDENDUM NO. 2	NOTICE
	09/2022	BP	ADDENDUM NO. 3	NOTICE
Д				0 ½ 1
Δ				
Д				IF THIS BAR DOES
Δ				NOT MEASURE 1"
Δ				THEN DRAWING IS NOT TO SCALE
NO	DATE	BV	DEVICION	1

JL DRAWN BP CHECKED







MAHLER WATER RECLAMATION FACILITY IMPROVEMENTS PROJECT PHASE 1


POWER CONDUIT SCHEDULE 1

E-020

PROJECT NO.: 936-50-21-09 SCALE: AS NOTED DATE:

79 of 135

SHEET

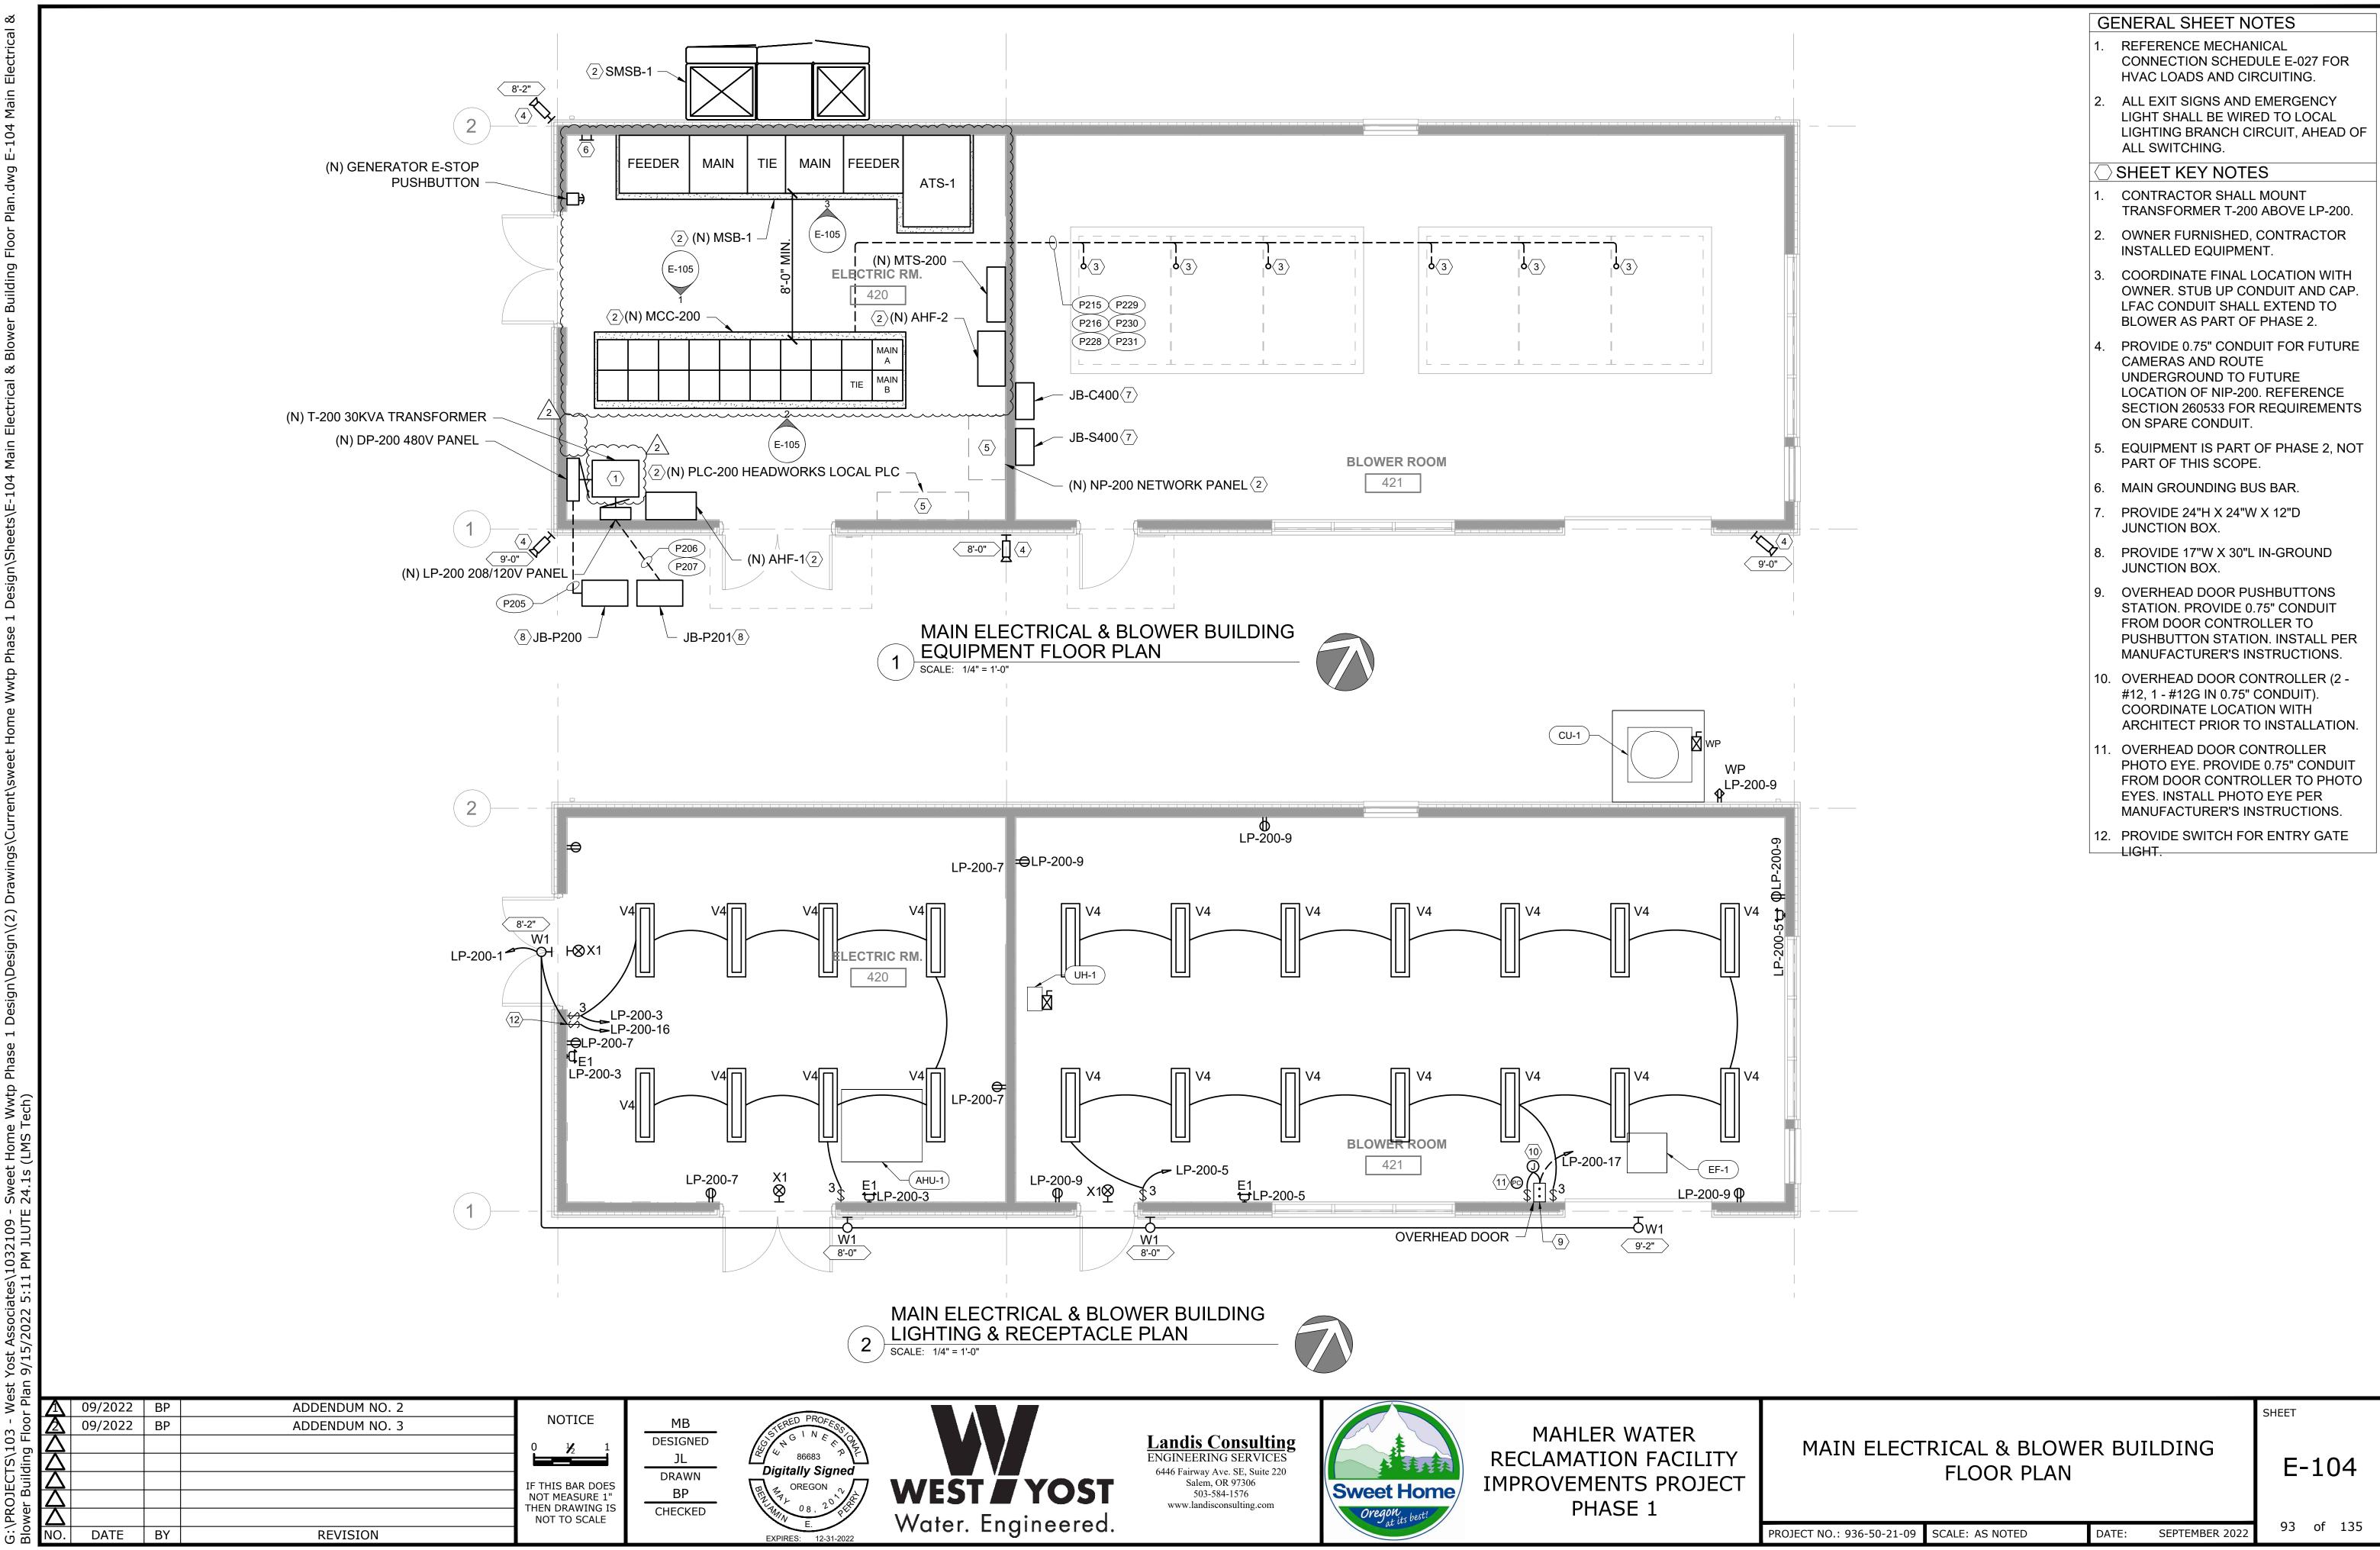

REVISION

EXPIRES: 12-31-2022

93 of 135 SEPTEMBER 202

PROJECT NO.: 936-50-21-09

SCALE: AS NOTED

DATE:


ETHERNET SWITCH SPD BLANK	ETHERNET POWER SUPPLY MTS-200 FEED A	(FUTURE) MS-310-10 (FUTURE) MS-310-11	(FUTURE) VFD-310-01	(FUTURE) VFD-430-01	(FUTURE) VFD-410-01	(FUTURE) VFD-411-01	(FUTURE) MS-330-01 (FUTURE) MS-320-01	
MAIN A	BLANK	(FUTURE) MS-310-20 (FUTURE) MS-310-21	(FUTURE)	(FUTURE)	(FUTURE)	(FUTURE)	BLANK (SPARE	FUTURE FUTURE SECTION
CIRCUIT BREAKER	(FUTURE) VFD-310-05	(FUTURE) MS-410-01 (FUTURE) MS-411-01	VFD-310-02	VFD-430-02	VFD-400-01	VFD-400-03	FOR VFD-400-05)	

MCC-200 NORTH ELEVATION - A-SIDE SCALE: 3/4" = 1'-0"

	BLANK	(FUTURE)	(FUTURE) MS-412-01			(FUTURE) MS-310-30	ETHERNET POWER SUPPLY	ETHERNET SWITCH
	BLANK	VFD-412-01	BLANK	(FUTURE) VFD-430-02	(FUTURE) VFD-310-03	(FUTURE)		SPD
			<i>BE</i> ,			MS-310-31	MTS-200 FEED B	BLANK
	BLANK							
FUTURE FUTURE SECTION				BLANK	(FUTURE) VFD-320-02			
		BLANK						
		(SPARE FOR	(FUTURE) VFD-400-04	BLANK	BLANK	(FUTURE) VFD-400-02	MAIN B CIRCUIT	TIE CIRCUIT
	BLANK	VFD-400-06)					BREAKER	BREAKER
				BLANK	BLANK			
	BLANK			BLANK	BLANK			
	1		1	DLAINK	DLAINK		<u> </u>	1

MCC-200 SOUTH ELEVATION - B-SIDE

SCALE: 3/4" = 1'-0"

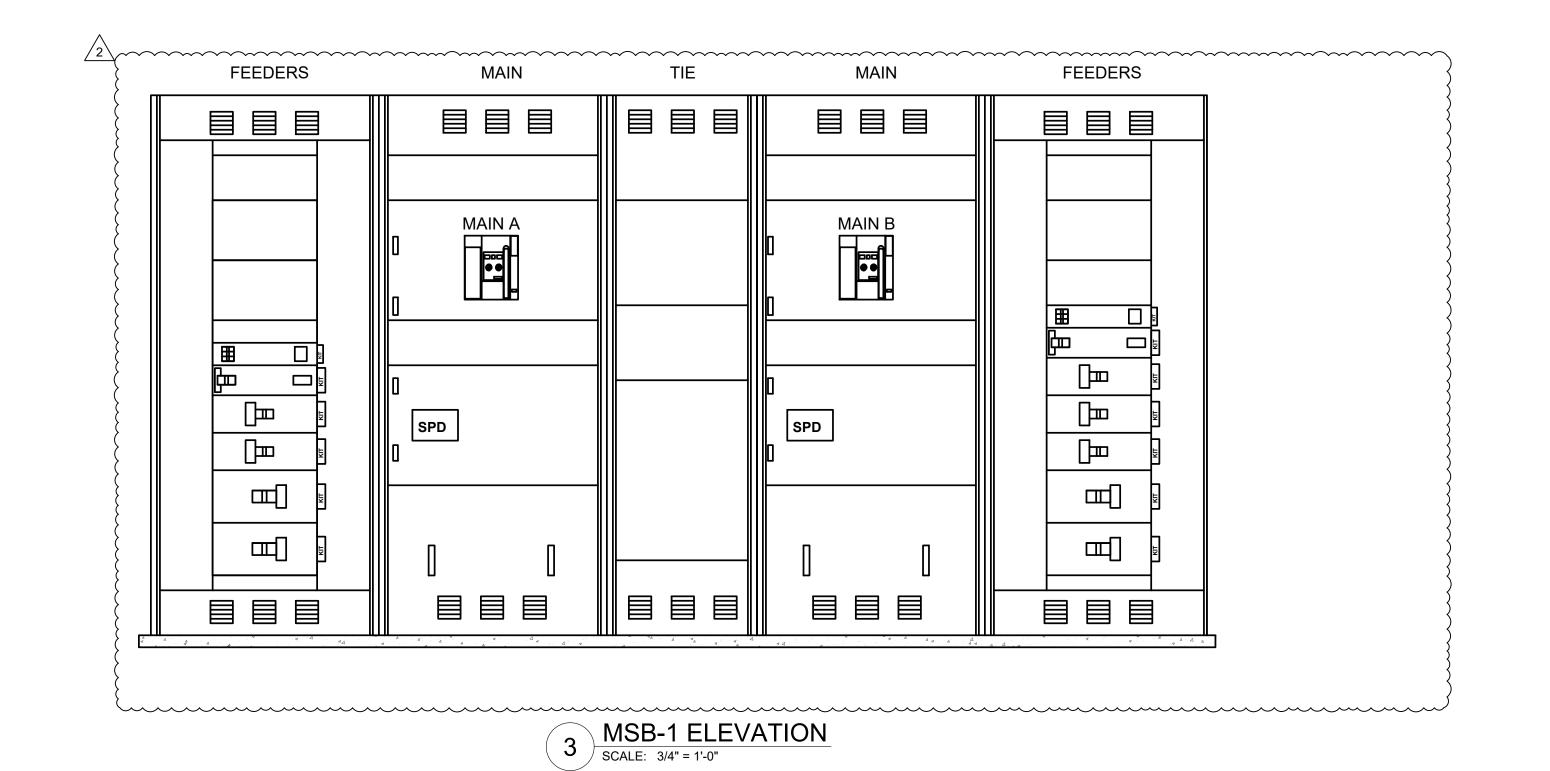

Sweet Home Oregon at its best!

MAHLER WATER IMPROVEMENTS PROJECT PHASE 1

MAIN ELECTRICAL & BLOWER BUILDING MCC-200 & MSB-1 ELEVATIONS

E-105

SHEET

PROJECT NO.: 936-50-21-09 SCALE: AS NOTED DATE:

A	00/2022	DD	ADDENDUM NO. 3	1
4	09/2022	BP	ADDENDUM NO. 2	NOTICE
	09/2022	BP	ADDENDUM NO. 3	NOTICE
Δ				0 ½ 1
Δ				IF THIS BAR DOES
Δ				NOT MEASURE 1"
Δ				THEN DRAWING IS NOT TO SCALE
NO.	DATE	BY	REVISION	

DESIGNED JL
DRAWN
BP
CHECKED



Landis Consulting ENGINEERING SERVICES 6446 Fairway Ave. SE, Suite 220 Salem, OR 97306 503-584-1576 www.landisconsulting.com WEST YOST Water. Engineered.

RECLAMATION FACILITY

