City of Sweet Home
1400 24th Avenue
Sweet Home, OR 97386
541-367-6359
Fax 541-367-7592
www.sweethomeor.gov

Public Works Department

CHANGE ORDER

Change Order No. 1 **Request Date:** 4/26/22

Project: WATER TREATMENT PLANT FINISHED WATER AND BACKWASH PUMPING PROJECT

Location: 1500 47th Ave, Sweet Home OR 97386

Owner: City of Sweet Home

Contractor: Pacific Excavation, Inc

Description of Change:

Add motor space heater to backwash pump as per DEIC-01.

Time of Completion:

Contract completion date is hereby unchanged.

Contract Summary:

Original Contract Sum	$ 273,800.00
Previous Additions	$ 0
Previous Deductions	$ 0
Previous Total	$ 273,800.00
This Change (Addition)	$ 4,083.26
This Change (Deduction)	$ 0
New Total	$ 277,883.26

Accepted by:

Contractor

Project Manager
Title

5/6/2022
Date

Owner

City of Sweet Home
City Manager Pro Tem
Title

5/6/2022
Date

WEST YOST
Water. Engineered.

5 Centerpointe Drive
Suite 130
Lake Oswego OR 97035

503.451.4500 phone
530.756.5991 fax
westyost.com

DESIGN ENGINEER INITIATED CHANGE (DEIC)

Subject **DEIC 01 – Pump Space Heater** DEIC No. **01**

Contract Document Reference **E106, E601, E602** Date: **03/30/2022**

Owner: **City of Sweet Home** Project No.: **936-50-20-03**

Project Name: **WWTP Condition Assessment Improvements Project**

Contractor: **Pacific Excavation, Inc.**

Is there a Cost Impact associated with this change? ☒ Yes ☐ No ☐ Possibly

Is there a Time Impact associated with this change? ☐ Yes ☐ No ☒ Possibly

Modify the Contract Documents as follows:

Refer to the attached modified Contract Documents:

Explanation:

Spec 11352 called for a space heater to mitigate condensation where specified or recommended by the manufacturer. Within submittal 06, a space heater was included in the manufacturer's submittal, but the design did not account for the hardware and power supply for this. Please refer to the attached drawings to see power supply changes to accommodate the space heater.

By: **Ruby Lang (West Yost), Trish Rice (Sweet Home), Michael Henning (Landis), Gary Jenks (TAG)** Date 04/12/2022

POWER CONDUIT / CONDUCTOR SCHEDULE

CONDUIT ID NO.	CONDUIT QUANTITY	CONDUIT SIZE	CONDUCTORS PER CONDUIT UNGROUNDED	GROUNDED	GROUNDING	CABLE	SPARE	FROM	TO	DESCRIPTION	NOTES
P101	2	3.0 INCH	3 - #350	1 - # 1/0	1 - #1	-	-	MCP601	MCC602	UTILIZE EXISTING CONDUITS. THERE ARE THREE CONDUITS, ONE SHALL REMAIN SPARE.	-
P102	1	1.25 INCH	3 - #4	-	1 - #8	-	-	MCC601	50A AHF	-	-
P103	1	1.25 INCH	3 - #2	-	1 - #6	-	-	MCC602	100A AHF	-	-
P104	1	2.0 INCH	3 - #2/0	-	1 - #6	-	-	MCC602	(N) BACKWASH PUMP	-	-
P105	1	0.75 INCH	1 - #12	1 - #12	1 - #12	-	-	PANEL L602	(N) CONTROL PANEL	-	-
P106	1	0.75 INCH	1 - #12	1 - #12	1 - #12	-	-	PANEL L602	(N) MOTORIZED VALVE	-	-
P107	1	0.75 INCH	2 - #14	-	1 - #14	-	-	MCC602	(N) CPT ENCLOSURE	-	-
P108	1	0.75 INCH	1 - #14	1 - #14	1 - #14	-	-	(N) CPT ENCLOSURE	(N) BACKWASH PUMP HEATER	-	-

NOTES:

CONTROL CONDUIT / CONDUCTOR SCHEDULE

CONDUIT ID NO.	CONDUIT QUANTITY	CONDUIT SIZE	CONDUCTORS PER CONDUIT UNGROUNDED	GROUNDED	GROUNDING	CABLE	SPARE	FROM	TO	DESCRIPTION	NOTES
C101	1	1.0 INCH	-	-	-	3 - TSP	-	MCC601 CT'S	50A AHF	-	-
C102	1	1.0 INCH	-	-	-	3 - TSP	-	MCC602 CT'S	100A AHF	-	-
C103	1	2.5 INCH	-	-	-	3 - CAT6	-	INSTRUMENTATION JUNCTION BOX	(N) CONTROL PANEL	MOTORIZED VALVE AND TWO PRESSURE TRANSMITTERS	-
C104	1	1.0 INCH	-	-	-	1 - CAT6	-	MCC601 FWP601 VFD	(N) CONTROL PANEL	NEW CONDUIT TO CABLE TRAY. UTILIZE CABLE TRAY FOR CAT6 HOMERUN.	-
C105	1	1.0 INCH	-	-	-	3 - CAT6	-	MCC602 FWP402 VFD MCC602 FWP403 VFD (N) BACKWASH PUMP SS	(N) CONTROL PANEL	NEW CONDUIT TO CABLE TRAY. UTILIZE CABLE TRAY FOR CAT6 HOMERUN.	-
C106	1	0.75 INCH	-	-	-	1 - CAT6	-	PRESSURE TRANSMITTER	(N) INSTRUMENTATION JUNCTION BOX	-	-
C107	1	0.75 INCH	-	-	-	1 - CAT6	-	PRESSURE TRANSMITTER	(N) INSTRUMENTATION JUNCTION BOX	-	-
C108	1	0.75 INCH	-	-	-	1 - CAT6	-	INSTRUMENTATION JUNCTION BOX	MOTORIZED VALVE	-	-
C109	-	-	-	-	-	-	-	-	-	-	-
C110	-	-	-	-	-	-	-	-	-	-	-
C111	-	-	-	-	-	-	-	-	-	-	-
C112	-	-	-	-	-	-	-	-	-	-	-
C113	-	-	-	-	-	-	-	-	-	-	-
C114	-	-	-	-	-	-	-	-	-	-	-
C115	-	-	-	-	-	-	-	-	-	-	-
C116	-	-	-	-	-	-	-	-	-	-	-

NOTES:

PANEL NAME: L602
VOLT/PHASE: 208/120V, 3Ø
NUM. POLES: 42
AIC RATING: 42,000
NOTES: EXISTING PANEL
REF. KEY NOTE #:

LOCATION: XXX
FED FROM: MCC 601 VIA XFMR 602
BREAKER MOUNTING: BOLTED
MAIN BREAKER AMPS: 175
BUS RATING AMPS: 225
SPD: NO

NOTES	LOAD DESCRIPTION	LOAD TYPE	VA L1	VA L2	VA L3	TRIP RATING AMPS	CIRCUIT NUMBER	CIRCUIT NUMBER	TRIP RATING AMPS	VA L1	VA L2	VA L3	LOAD TYPE	LOAD DESCRIPTION	NOTES
	CU-1		-			25	1	2	30	-				SPARE	
				-			3	4			-				
	SPARE				-	30	5	6				-			
			-				7	8		-					
	CU-2			-		40	9	10	20		-			SPARE	
					-		11	12				-			
	RCPT: P201		-			20	13	14	20	-				EWH-2	
	RCPT: P202			-		20	15	16	20		-			CP101	
	RCPT: ACH201				-	20	17	18	20			-		CP210	
	POLYMER MIX UNIT		-			20	19	20	20	500				(N) CONTROL PANEL	[1]
	RCPT: CL201			-		20	21	22	20		500			(N) MOTORIZED VALVE	[1]
	RCPT: SA201				-	20	23	24	20			-		SPARE	
	RCPT: F201		-			20	25	26	20	-				SPARE	
	RCPT: PROCESS AREA			-		20	27	28	20		-			EWH-1	
	RCPT: PROCESS AREA				-	20	29	30	20			-		UH-1, 2, 4, 8 & 10	
	RCPT: FILTER 2					20	31	32	20					F-2	
	SPARE			-		20	33	34	20		-			FC-1	
	SPARE				-	20	35	36				-			
	RCPT: PROCESS AREA		-			20	37	38	20	-				EF-1	
	RCPT: PROCESS AREA			-		20	39	40	20		-			RCPT: SCM AIR012 / 022	
	RCPT: CHEM AREA				-	20	41	42	20			-		RCPT: CHEM AREA	

TOTAL LOAD:	0	0	0	TOTAL LOAD:	500	500	0
COMBINED LOAD:	500	500	0	CONNECTED LOAD: 1,000	DEMAND LOAD: 0		
					DEMAND AMPS: 0		

Load Type Key		Demand Factor	Connected Load	Demand Load
R	General Purpose Receptacle	100% First 10KVA, 50% thereafter	0	0
L	Lighting	125% Load	0	0
M1	Largest Motor	125% Load	0	0
M	Motor	100% Load	0	0
A	Appliance	100% Load	0	0
H	HVAC	100% Load	0	0
K	Kitchen	65% Load	0	0
E	Equipment	100% Load	0	0
T	Transformer	100% Load	0	0
W	Welder	100% Load	0	0
RV	Recreational Vehicle	100% Load	0	0

6 - Units of Equipment - See NEC Table 220.55

XX - RV Sites - See NEC Table 551.71 (A)

NOTES: [1] CONNECT TO EXISTING SPARE 20A, 120V, 1-PHASE CIRCUIT BREAKER FOR NEW LOAD AS SHOWN.

REGISTERED PROFESSIONAL ENGINEER 86663 Digital Signature OREGON MAY 08, 2014 BENJAMIN E. FOSHEY EXPIRES: 12-31-2022

QC REVIEW: _____
DATE: _____

THIS LINE IS 1 INCH AT FULL SCALE IF NOT SCALE ACCORDINGLY

SCALE : _____
DRAWN BY : EJC
DESIGNED BY : MH
PROJ. MGR. : _____

No.	ZONE	REVISIONS	BY	DATE
1		CO#1	EJC	3/2022

Landis Consulting
ENGINEERING SERVICES
Salem | Lake Oswego
503-584-1576
www.landisconsulting.com

Sweet Home

SWEET HOME
FINISHED WATER AND BACKWASH PUMPING SYSTEMS IMPROVEMENTS

CONDUIT AND PANEL SCHEDULES

JOB NUMBER 936-50-20-03
DRAWING NUMBER E106
SHEET NUMBER 13 OF 15
REVISION

G:\PROJECTS\103 - West Yost Associates\1032007 - Sweet Home WTP\Design\(2) Drawings\Current\Sweet Home WTP\Sheets\E106 Conduit and Panel Schedules.dwg 3-31-22 09:25:09 AM eclose

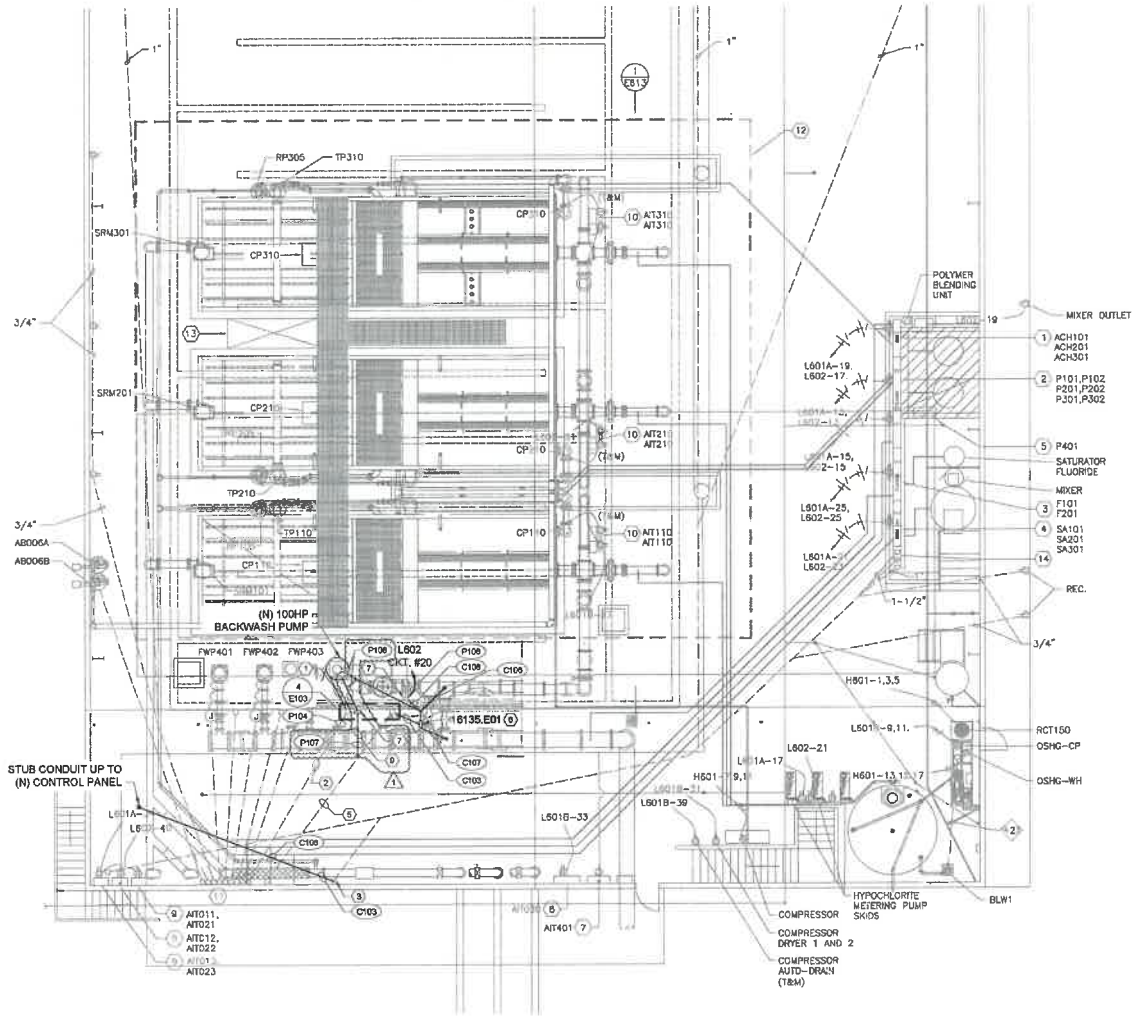

REFERENCE KEY NOTES

DIVSION 16

16135.E01 - GENERAL ENCLOSURES

SHEET KEY NOTES

1. EXTEND 2.5" CONDUIT FROM (E) SPARE CONDUIT TO MOTOR CONNECTION. PROVIDE CONDUCTORS AS SHOWN ON ONE-LINE.
2. UTILIZE (E) SPARE 2.5" CONDUIT FOR NEW CONDUCTORS FROM SOFT STARTER IN MCC602 TO (N) BACKWASH PUMP.
3. INTERCEPT (E) SPARE 2.5" CONDUIT AND EXTEND IT ALONG THE UNDERSIDE OF THE ABOVE MEZZANINE TO THE LOCATION OF (N) CONTROL PANEL.
4. STUB (N) CONDUIT UP TO (N) CONTROL PANEL LOCATION.
5. PROVIDE (1) CAT6 CABLE FROM (N) PRV TO (N) CONTROL PANEL. CAT6 CABLE SHALL PASS THROUGH (N) JUNCTION BOX AS SHOWN. CABLE SHALL NOT BE TERMINATED IN JUNCTION BOX.
6. PROVIDE INSTRUMENTATION JUNCTION BOX WITH TERMINAL STRIP. MOUNT JUNCTION BOX TO COLUMN. EXTEND (E) CONDUIT TO JUNCTION BOX LOCATION. PROVIDE (N) 1" CONDUIT FROM JUNCTION BOX TO (N) PRV.
7. PROVIDE 120V CIRCUIT FROM (E) LP602 CIRCUIT 22 TO (N) MOTORIZED VALVE. UTILIZE (E) SPARE 20A, 1-POLE CIRCUIT BREAKER.
8. (N) CPT ENCLOSURE PROVIDED BY INTEGRATOR OF RECORD AND INSTALLED BY CONTRACTOR. PROVIDE STRUT SUPPORTS AS REQUIRED TO SUPPORT ENCLOSURE.
9. CONDUIT TO BE ROUTED OVERHEAD TO (N) CPT ENCLOSURE. PROVIDE STRUT SUPPORTS AS REQUIRED TO SECURITY CONDUIT.

REGISTERED PROFESSIONAL ENGINEER 86883 OREGON
Digital Signature
MAY 06, 2013
BENJAMIN E. JONES
EXPIRES: 12-31-2022

QC REVIEW: _____
DATE: _____

THIS LINE IS 1 INCH
AT FULL SCALE IF NOT SCALE ACCORDINGLY

SCALE : _____
DRAWN BY : EJC
DESIGNED BY : MH
PROJ. MGR. : _____

No.	ZONE	REVISIONS	BY	DATE
1		CO#1	EJC	3/2022

Landis Consulting
ENGINEERING SERVICES
Salem | Lake Oswego
503-584-1576
www.landisconsulting.com

Sweet Home

SWEET HOME
FINISHED WATER AND BACKWASH PUMPING SYSTEMS IMPROVEMENTS

PROCESS POWER PLAN - FIRST FLOOR

JOB NUMBER 936-50-20-03
DRAWING NUMBER **E601**
SHEET NUMBER 14 OF 15
REVISION

G:\PROJECTS\103 - West Yost Associates\1032007 - Sweet Home WTP\Design\(2) Drawings\Current\Sweet Home WTP\Sheets\1032007-E601 Process Power Plan - First Floor.dwg 3-31-22 09:25:27 AM eclose

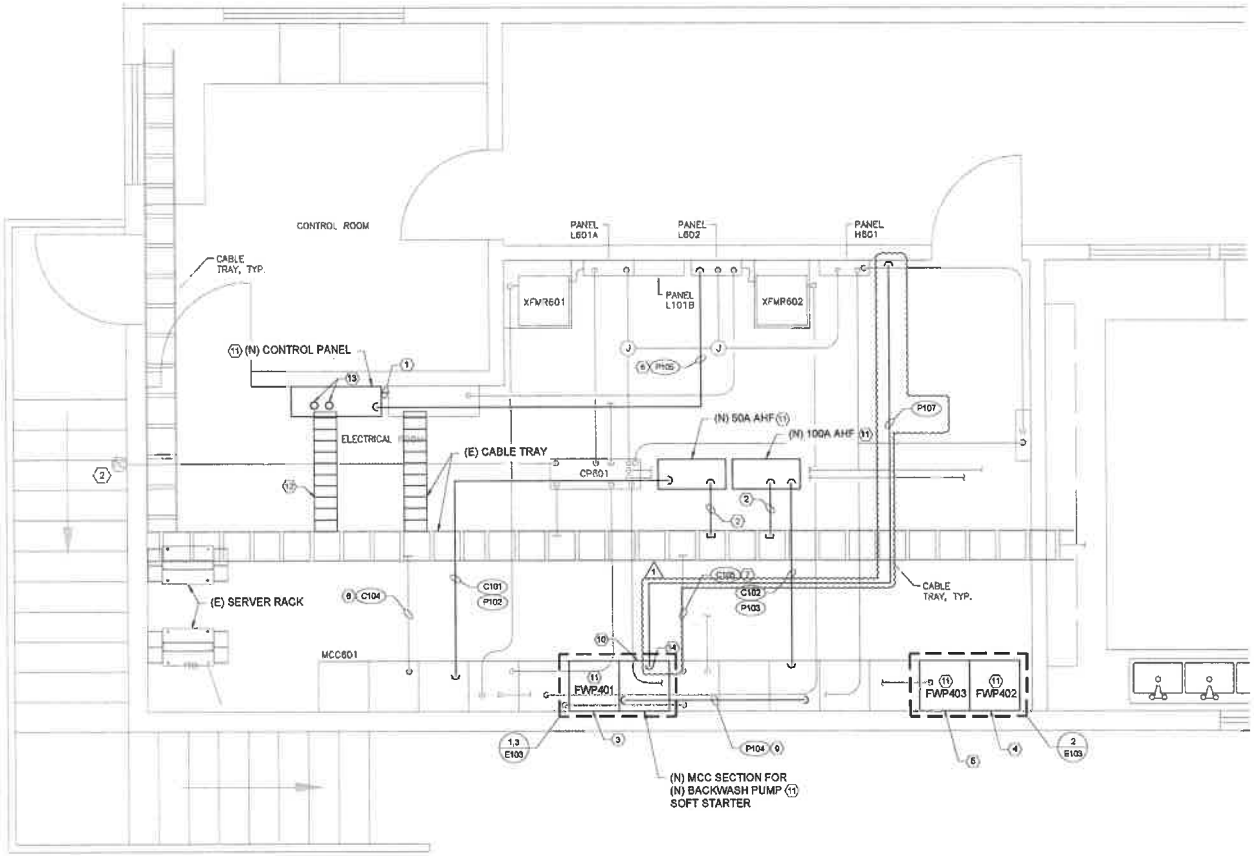

1 SECOND FLOOR PROCESS POWER AND SIGNAL PLAN
SCALE: NTS

SHEET KEY NOTES

1. PROVIDE (4) 2" CONDUIT NIPPLES BETWEEN (E) CP101 AND (N) CONTROL PANEL AS SHOWN.
2. PROVIDE (1) 1" CONDUIT FROM AHF STUBBED OUT TO (E) CABLE TRAY. PROVIDE (1) CAT6 CABLE FROM AHF TO (N) CONTROL PANEL.
3. SEE E102 AND E103 FOR INFORMATION ON SCOPE OF WORK FOR STARTER FWP401 IN MCC601.
4. SEE E102 AND E103 FOR INFORMATION ON SCOPE OF WORK FOR STARTER FWP402 IN MCC602.
5. SEE E102 AND E103 FOR INFORMATION ON SCOPE OF WORK FOR STARTER FWP403 IN MCC602.
6. PROVIDE (1) CAT6 CABLE FROM FWP01 VFD TO (N) CONTROL PANEL. UTILIZE (E) CONDUIT FROM MCC601 TO (E) CABLE TRAY AS SHOWN. ROUTE CAT6 CABLES THROUGH (E) CABLE TRAY TO (E) CP-101 AND THROUGH THE CONDUIT NIPPLES TO (N) CONTROL PANEL.
7. PROVIDE (1) CAT6 CABLE FROM FWP402 VFD, (1) CAT6 CABLE FROM FWP403 VFD, (1) CAT6 CABLE FROM BACKWASH PUMP SOFT START, ALL THREE TO THE (N) CONTROL PANEL. UTILIZE (E) CONDUIT PATHWAY FROM MCC602 TO (E) CABLE TRAY AS SHOWN. ROUTE CAT6 CABLES THROUGH (E) CABLE TRAY TO (E) CP-101 AND THROUGH THE CONDUIT NIPPLE TO (N) CONTROL PANEL.
8. PROVIDE 120V CIRCUIT FROM (E) LP602 CIRCUIT 20 TO (N) CONTROL PANEL. UTILIZE (E) SPARE 20A, 1-POLE CIRCUIT BREAKER.
9. PROVIDE CABLING FROM CIRCUIT BREAKER IN MCC602 TO (N) BACKWASH PUMP SOFT START MCC SECTION. INTENT IS TO RUN CABLING INSIDE (E) MCC602 CABLE THROUGH TO (N) MCC SECTION. SEE E102 FOR MORE INFORMATION.
10. PROVIDE (1) CAT6 CABLE FROM (N) BACKWASH PUMP SOFT STARTER TO THE (N) CONTROL PANEL. TUILIZE (E) WIRING TROUGH IN (E) MCC602 AND (E) CONDUIT PATHWAY FROM MCC602 TO (E) CABLE TRAY AS SHOWN. ROUTE CAT6 CABLES THROUGH (E) CABLE TRAY TO (E) CP-101 AND THROUGH THE CONDUIT NIPPLE TO (N) CONTROL PANEL.
11. EQUIPMENT PROVIDED BY INTEGRATOR OF RECORD, CONTRACTOR TO INSTALL. SEE E102 FOR ADDITIONAL INFORMATION.
12. PROVIDE NEW WIRE BASKET CABLE TRAY FROM EXISTING CABLE TRAY TO NEW CONTROL PANEL. MATCH WIDTH, HEIGHT, AND TYPE OF EXISTING CABLE TRAY. PROVIDE ALL ACCESSORIES TO CONNECT TO EXISTING TRAY. CONNECT INTO AND EXTEND EXISTING CABLE TRAY GROUNDING SYSTEM, MATCH CONDUCTOR SIZE.
13. PROVIDE (3) 2" EMT CONDUITS FORM (N) CONTROL PANEL TO (N) CABLE TRAY. PROVIDE GROUND BUSHINGS CONNECT TO GROUNDING SYSTEM ON TRAY.
14. CONNECT TO NORMALLY CLOSED AUXILLIARY CONTACT IN SOFT START DRIVE. COORDINATE EXACT CONNECTION WITH INTEGRATOR OF RECORD.

REGISTERED PROFESSIONAL ENGINEER 56683 Digital Signature OREGON MAY 08, 2012 BENJAMIN E. LANDIS EXPIRES 12-31-2022

QC REVIEW: _____
DATE: _____

THIS LINE IS 1 INCH
AT FULL SCALE IF NOT SCALE ACCORDINGLY

SCALE : _____
DRAWN BY : EJC
DESIGNED BY : MH
PROJ. MGR. : _____

No.	ZONE	REVISIONS	BY	DATE
1		CO#1	EJC	3/2022

Landis Consulting
ENGINEERING SERVICES
Salem | Lake Oswego
503-584-1576
www.landisconsulting.com

Sweet Home

SWEET HOME
FINISHED WATER AND BACKWASH PUMPING SYSTEMS IMPROVEMENTS

PROCESS POWER AND SIGNAL PLAN - SECOND FLOOR

JOB NUMBER 936-50-20-03
DRAWING NUMBER E602
SHEET NUMBER 15 OF 15
REVISION

G:\PROJECTS\103 - West Yost Associates\1032007 - Sweet Home WTP\Design\(2) Drawings\Current\Sweet Home WTP\Sheets\1032007-E602 Process Power and Signal Plan - Second Floor.dwg 3-31-22 08:25:42 AM eclose

79 N Danebo Ave
Eugene, OR 97402
PH: 541-726-7380
FX: 541-726-7943

REQUEST FOR CHANGE

Date: 4/26/2022

To: Trish Rice
Sweet Home WTP

From: Beau Solesbee

Project: Sweet Home WTP Pump

RE: PR 1 Pump Space Heater

Below and Attached is the Pricing and Associated Details to Perform the Following Scope of Work:

* Price includes the cost for the Pump Space Heater per DEIC No. 1.

Total Price for PR	**1**	**$**	**4,083.26**
Additional Contract Days			

Please let me know if you have any questions.

Thank you,
Beau Solesbee
Pacific Excavation
Project Manager

Pacific Excavation

TIME & MATERIALS DAILY WORKSHEET

PROJECT: Sweet Home WTP Pump
DATE: 4/26/2022
PR No. 1
Contract No.: 2204

DESCRIPTION OF WORK: Pump Space Heater

LABOR	UNIT PRICE	Heater						TOTAL UNITS	TOTAL COST
		HOURS							
Superintendent / Project Mgr	$ 75.00							0	$ -
Foreman	$ 68.84							0	$ -
Foreman OT	$ 92.90							0	$ -
Operator	$ 64.59							0	$ -
Operator OT	$ 87.53							0	$ -
Laborer	$ 55.27							0	$ -
Laborer OT	$ 73.60							0	$ -
Driver	$ 37.18							0	$ -
Driver OT	$ 50.70							0	$ -
EQUIPMENT									
Foreman Pick Up / Small Tools	$ 15.00							0	$ -
Hand Compactor / Saws	$ 10.00							0	$ -
Diesel Plate Compactor	$ 20.00							0	$ -
								0	$ -
D3 Dozer	$ 59.00							0	$ -
D4 Dozer	$ 69.00							0	$ -
D5 Dozer	$ 85.00							0	$ -
D6 Dozer	$ 109.00							0	$ -
								0	$ -
Backhoe	$ 45.00							0	$ -
Backhoe w/ HoPac or Hammer	$ 55.00							0	$ -
Skid Steer	$ 33.00							0	$ -
IT Loader	$ 68.00							0	$ -
Forklift	$ 45.00							0	$ -
Aerial Lift	$ 45.00							0	$ -
								0	$ -
Mini Excavator	$ 40.00							0	$ -
Mini Exc w/ Breaker	$ 60.00							0	$ -
120 Excavator	$ 85.00							0	$ -
120 Exc w/ Breaker	$ 125.00							0	$ -
220 Excavator	$ 125.00							0	$ -
220 Exc w/ Breaker	$ 175.00							0	$ -
300 Excavator	$ 160.00							0	$ -
400 Excavator	$ 185.00							0	$ -
								0	$ -
Grader	$ 90.00							0	$ -
Mini Double Drum Roller	$ 23.00							0	$ -
Smooth Drum Roller	$ 62.00							0	$ -
Pad Drum Roller	$ 67.00							0	$ -
615 Scraper	$ 175.00							0	$ -
Water Truck	$ 63.00							0	$ -
								0	$ -
End Dump Truck	$ 95.00							0	$ -
End Dump Truck & Pup	$ 115.00							0	$ -
Truck & Side-Dump Trailer	$ 115.00							0	$ -
Truck & 40-ft Flat Trailer	$ 110.00							0	$ -
Truck & Tilt Deck Trailer	$ 105.00							0	$ -
Artic / Off Road Truck	$ 115.00							0	$ -
								0	$ -
8x20 Shoring Box - per DAY	$ 125.00							0	$ -
8x4 Speed Shore - Per DAY	$ 75.00							0	$ -
8x20 Steel Sheet - Per DAY	$ 15.00							0	$ -
								0	$ -
MATERIALS									
	$ -							0	$ -
								0	$ -
								0	$ -
								0	$ -
								0	$ -
SUBCONTRACTS									
Electrical	$ 3,790.96	1						1	$ 3,790.96
								0	$ -
								0	$ -

Item Cost Totals	$ 3,790.96	$ -	$ -	$ -	$ -	$ -
Item Price Totals	$ 3,980.51	$ -	$ -	$ -	$ -	$ -

TOTALS

	Cost Totals	Mark Up Percent	Mark Up Amount	Subtotal
Labor	$ -	15%	$ -	$ -
Equipment	$ -	15%	$ -	$ -
Materials	$ -	15%	$ -	$ -
Subcontracts	$ 3,790.96	5%	$ 189.55	$ 3,980.51
		SUBTOTAL		**$ 3,980.51**
		ADDITIONAL BONDING - 2%		**$ 79.61**
		Corp Activity Tax .57%		**$ 23.14**
		TOTAL PRICE		**$ 4,083.26**

ELECTRICAL ENGINEERING FIRE PROTECTION HVAC MAINTENANCE PLUMBING UTILITY SUBMETERING

Solutions for a streamlined project

CHANGE ORDER
#E 01R

Project Name	Sweet Home WTP Finished Water & Backwash Pumping Systems Imp.
General Cont.	Pacific Excavation, Inc.
JET Division	Electrical
Time Extension	0

Date	4/20/2022
Description	Provide labor & material for pump motor space heater
Reference	DEIC No. 01
Notes	

QUANTITY	DESCRIPTION	PRICE PER	TOTAL
	Project Management		$ -
	Engineering/Design		$ -
	Administrative Labor		$ -
20	Labor	$ 95.00	$ 1,900.00
	Overtime Labor		$ -
1	LOT - Material	$ 1,083.38	$ 1,083.38
	Freight and/or Quick Ship		$ -
	Equipment		$ -
	SubContractors		$ -
	Permits		$ -
			$ -
			$ -
			$ -
		Subtotal	$ 2,983.38
	Overhead	15.00%	$ 447.51
	Profit	10.00%	$ 343.09
	Bond	0.00%	$ -
	Taxes	0.45%	$ 16.98
		0.00%	$ -
		Total	**$ 3,790.96**

Please indicate your authorization of these extra services by signing below and faxing or emailing this letter back to us with questions or comments. As part of this change order, Jet expressly reserves all time related claims, which claims the parties agree have not been compromised by execution of this change order. Time related claims include, but are not limited to, requests for extra time on the critical path, extended general conditions, and extended home office overhead. The parties further agree that due to the status of this Project, these time related claims are evolving and difficult to quantify. The parties will re-address any time related issues once the parties have an agreement on a project schedule that will achieve substantial completion.

Sincerely,

Jet Industries, Inc.

Accepted by: _____ Date: _____

JET INDUSTRIES

ELECTRICAL ENGINEERING FIRE PROTECTION HVAC MAINTENANCE PLUMBING UTILITY SUBMETERING

Solutions for a streamlined project

CHANGE ORDER
#E 01R
BACK-UP DATA FOR PRICE ON PAGE 1

QUANTITY	DESCRIPTION	PRICE PER	TOTAL
	120' 3/4-GRC Galv Rigid Conduit		$ 468.64
	40' PS-200-WH-10-PG P-STRUT SLOTTED EHSLOT 1-5/8" sq. PG 10'		$ 183.83
	AP-232SQ-EG S-STRUT SQ. BASE CONN HT3.5" LEN1.687" EG		$ 291.93
	500' XHHW-14-BLK-7STR-CU-500S/R		$ 75.04
	H075TB T&B 3/4" ZINC CONDUIT HUB		$ 31.56
	702-3/4-EG S-STRUT RGD COND CLP 3/4" 14GA EG STL		$ 32.38
			$ -
			$ -
			$ -
			$ -
			$ -
			$ -
			$ -
			$ -
			$ -
			$ -
			$ -
			$ -
			$ -
			$ -
		BACKUP SUBTOTAL	**$ 1,083.38**